LEGEND:	
	SCHEME BOUNDARY
	VACANT ALLOTABLE PLOTS
	TEMPORARY ENCROACHMENT
	ENCROACHMENT / DISPUTED

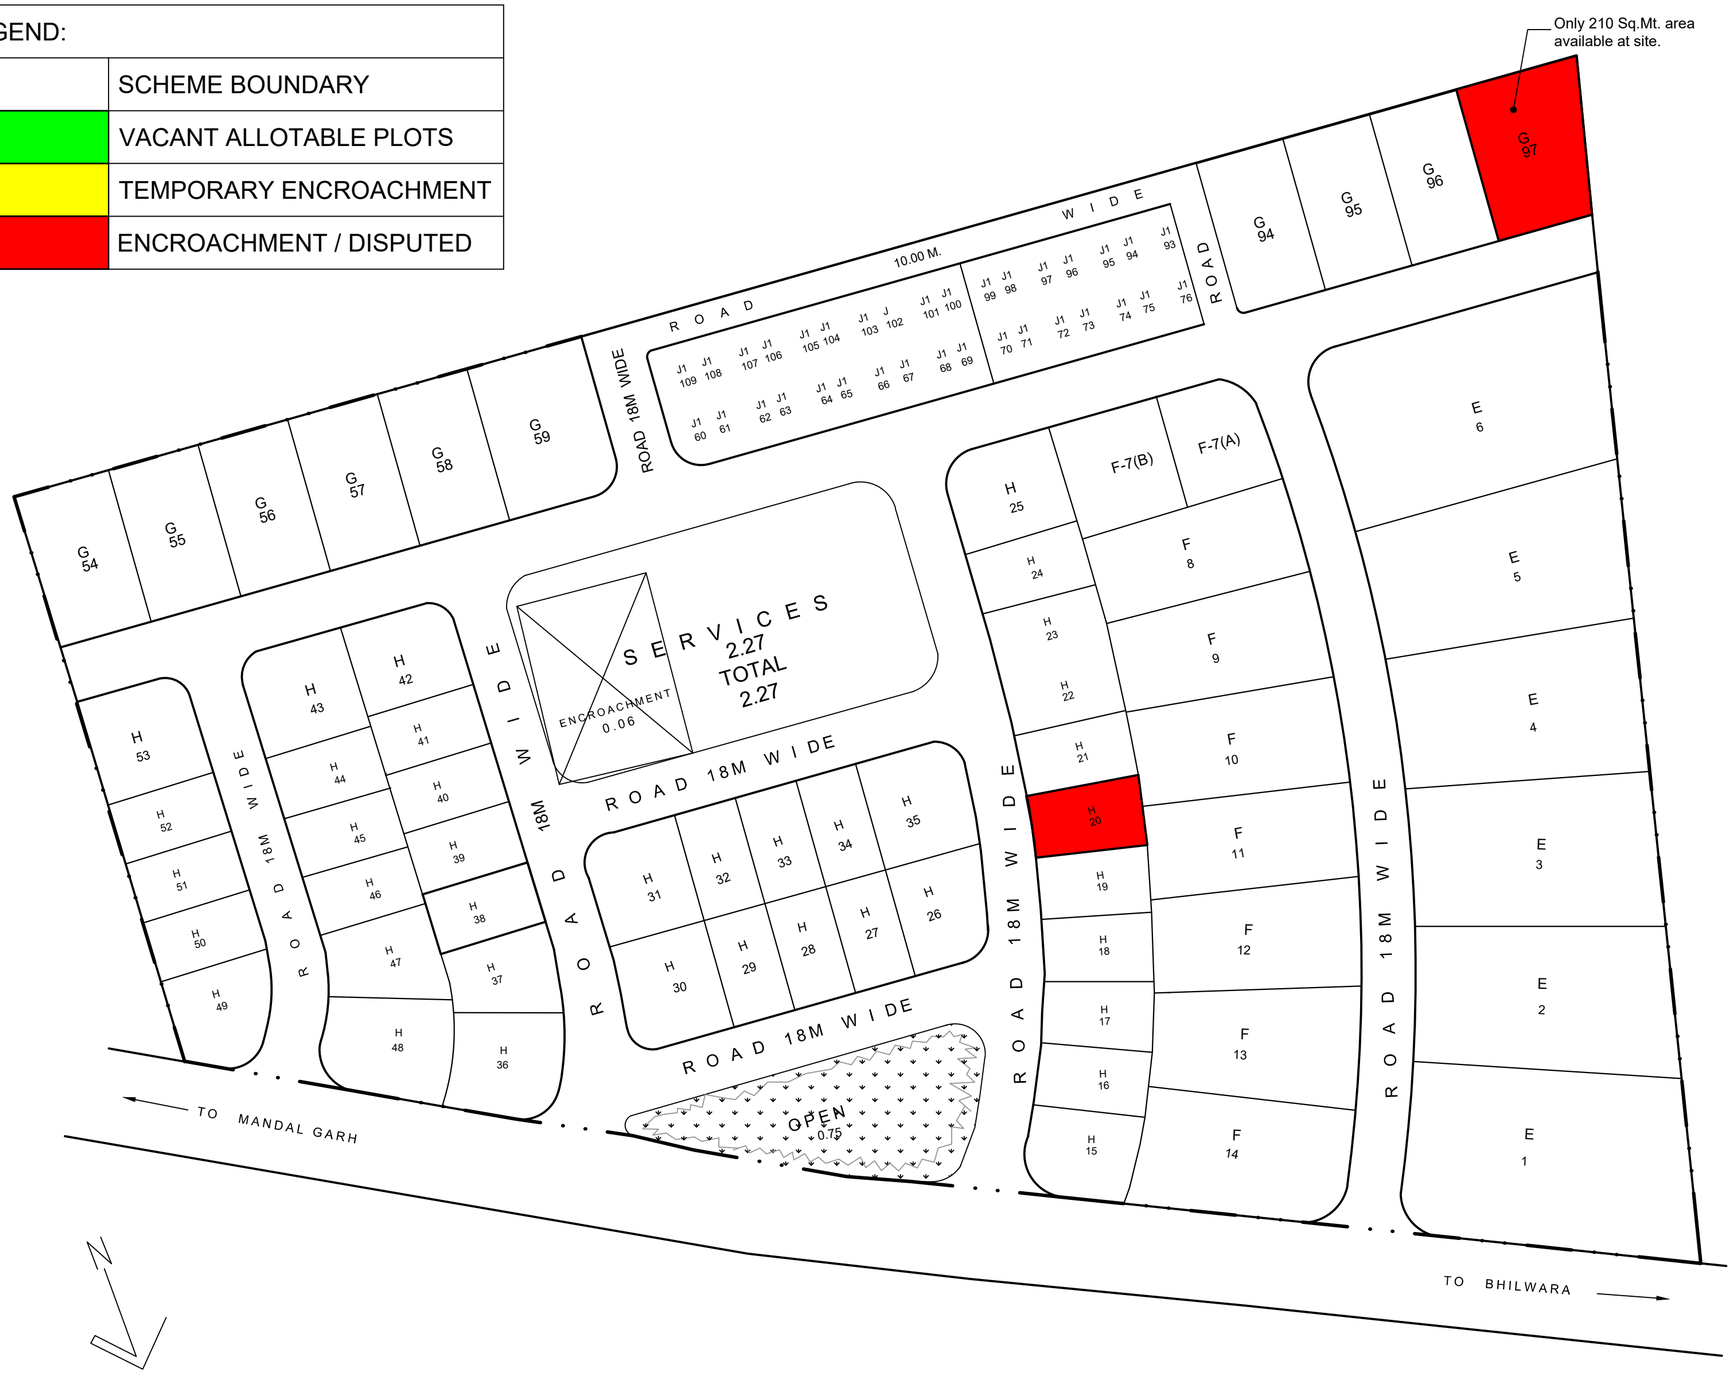

BIGOD

NOTE:-

1. PLOT No.G-60 TO 69 HAS BEEN DELETED.
2. REVISED VIDE U.O. NOTE F-4/1/23/81-82 DATED 4-12-81
3. REVISED PORTATION SHOWN IN RED COLOUR.
4. THIS DRG SUPER SEDES DRG No A& T.P/ 660/78

DEALT BY		APPROVED
Sd/-	Sd/-	Sd/-
(V.P. GAUTAM).	(B.S. PARIHAR)	(R.G. DANGAYACH)
Sr. DRAUGHTS MAN.	PLANNING ASSTT.	MANAGEER (ENGG).

SCHEDULE OF PLOTS:

TYPE	SIZE IN METRES	AREA IN SQM.	NOS.	SET BACKS		
				FRONT	SIDES	REAR
E	50.M x 100M	4000 M^2	6	12M	6M	6M
F	30.M x 65M	2000 M^2	8	10M	5M	5M
G	30.M x 50M	1000 M^2	10	10M	5M	5M
H	20.M x 35M	700 M^2	39	10M	5M	5M
J1	10.M x 20M	200 M^2	34	50M	3M. (ONE SIDE)	3M
		TOTAL	97			

LAND USE:

ARE UNDER SCHEME	35.72	ACRES
ARE UNDER PLOTS	24.00	ACRES
ARE UNDER ROADS	8.70	ACRES
ARE UNDER SERVICES	2.27	ACRES
ARE UNDER OPEN	.75	ACRES
TOTAL	35.72	ACRES

TOTAL ROAD LENGTH : 2.00 KM. (APPX.)

NOTE:

1. ENTRY OF PLOT ON MAIN BHILWARA- MANDHAL GARH ROAD IS NOT ALLOWED

LAY OUT PLAN FOR
INDUSTRIAL AREA
BIGOD DIST .DISTT. BHILWARA

DRAWN BY		SCALE	DRG. No
Sd/- (G.R. MAINI) SENIOR DRAUGHTS MAN	Sd/- (B.S. PARIHAR) PLANNING ASSISTANT	1 CM = 10M	A&TP /660/78 IP &' I/4/ DC.81

RAJASTHAN STATE INDUSTRIAL & MINERAL DEVOLOPMENT CORPORATION LTD., JAIPUR.

Sd/-	
ARCHITECT. TOWN PLANNER	(MANAGING DIRETOR)