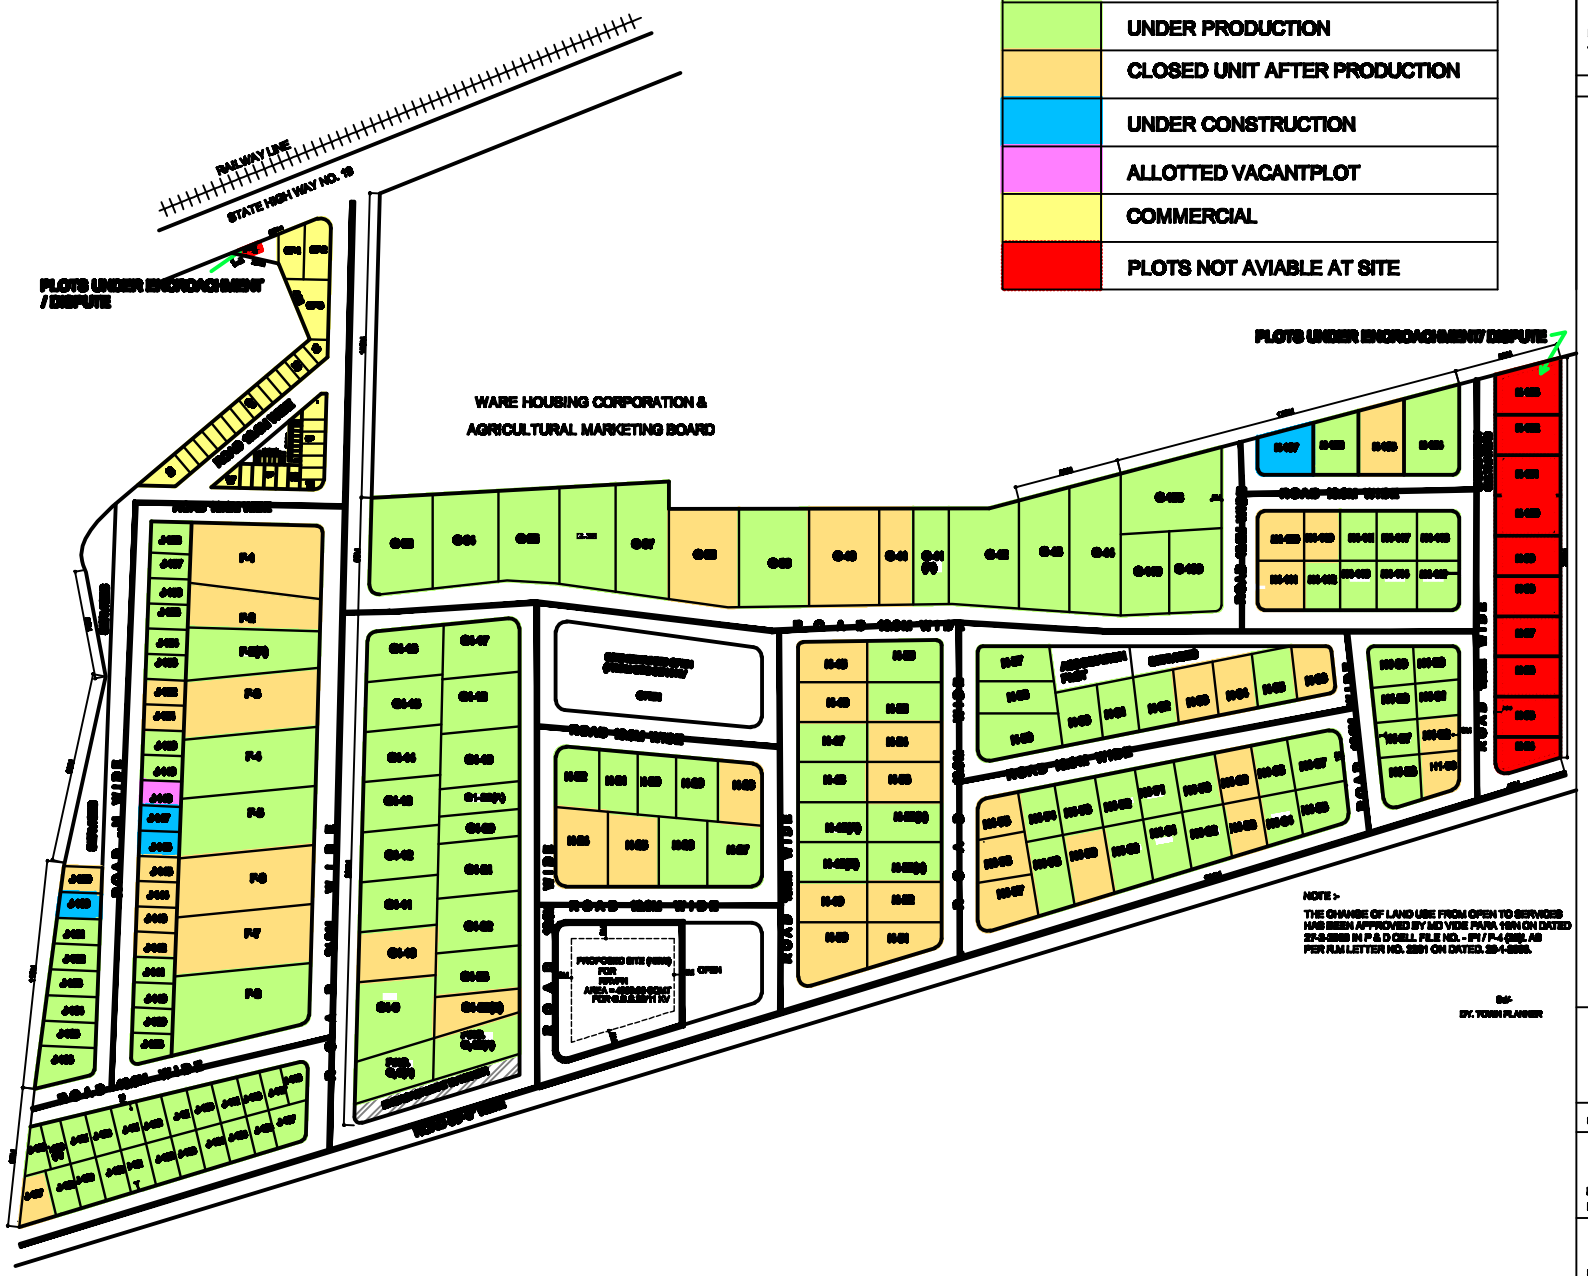

INDEX

	UNDER PRODUCTION
	CLOSED UNIT AFTER PRODUCTION
	UNDER CONSTRUCTION
	ALLOTTED VACANTPLOT
	COMMERCIAL
	PLOTS NOT AVIABLE AT SITE

SCHEDULE OF PLOTS (NEWLY PLAN)

~~SCHEDULE OF PLOTS~~ ~~(NEWLY PLAN)~~

TYPE	SIZE IN METER	AREA SQ.MT	ROS	EST	SHOPS	
					~~EST~~	
G_1	25.0 X 40.0	1000.0	25	5	3	2.5
H	20.0 X 35.0	700.0	45	4	~~3~~	2.0
H_1	20.0 X 25.0	500.0	37	3	~~3~~	~~2.0~~
J	12.50 X 22.0	275.0	51	3	1.5	1.5
F	~~25.00X40.00~~	~~2000~~	~~69~~	~~6~~	~~3~~	~~2.0~~
G	~~20.00X25.00~~	~~1000~~	~~12~~	~~3~~	~~1.5~~	~~1.5~~
TOTAL NO OF PLOTS			189			

LAND USE :-

AREA	UNDER	SCHEME	= 49.19 ACRES
"	"	PLOT	= 28.48 ACRES
"	"	ROADS	= 14.20 ACRES
"	"	SERVICES	= 0.82 ACRES
"	"	OPEN	= 2.88 ACRES
"	"	COMMERCIAL	= 0.80 ACRES

LAND ENCROACHED BY CULTIVATORS = 2.37 ACRES SHOWN IN THUS

LAND ENCROACHED BY CONSTRUCTING MANDIR AT SITE = .32 ACRES SHOWN IN THUS

LAND ENCROACHED BY ENTERPRENURES AT SITE = 1.88 ACRES SHOWN IN THUS

TOTAL AREA ENCROACHED = 2.69 ACRES

LENGTH OF ROADS - 3.0 K.M.

NOTE

1. THIS DRAWING HAS BEEN PREPARED ON THE SURVEY RECEIVED FROM UNIT OFFICE.
2. THIS DRAWING HAS BEEN SUPERCED OF DRG. NO. A & TP/8978.
3. THIS DRAWING HAS BEEN APPROVED BY CMD VIDE PARA 44/N ON DATED 14-12-2001 AS PER SR. RM NOTE ON DATED 7-12-2001 IN SECTION FILE.

LAY - OUT PLAN OF INDUSTRIAL AREA BHAWANI MANDI JHALAWAR.

SCALE :- 1CM = 10 MT.	DRG NO.	LP-I / 1002 / 2001 DT. 10-12-2001
Sd/- M.G. SARDA DMAN		
Sd/- SANJAY M. WAGHMARE ASSTT. TOWN PLANNER		
Sd/- PRAVEEN JAIN DY. TOWN PLANNER		N