


N

WELL

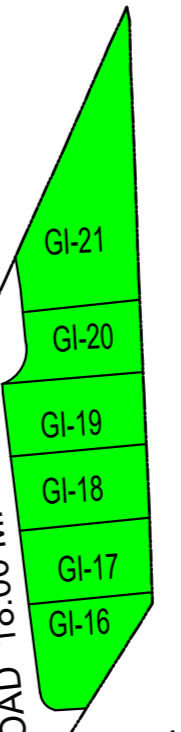

SCHEDULE OF SHOPS & GODOWN

TYPE	SIZE IN METERS	AREA IN SQM.	NOS.	REMARK
S	3.00X7.50 MTS. (INCH.1.50 MT P.L.)	22.50	17	
GW.	12.00 X 25.00	300.00	8	
TOTAL NOS. OF SHOPS & GODOWNS			17/8	

SCHEDULE OF PLOTS

TYPE	SIZE IN METERS	AREA IN SQM.	NOS.	SET BACK		
				FRONT	SIDES	REAR
E	50.00 X 80.00	4000 "	07	12.00M	6.00M.	6.00M.
F	30.00 X 65.00	2000 "	25	6.00 M	3.00M	3.00M.
G	30.00 X 50.00	1500 "	06	5.00 M	3.00M	3.00M.
G1	25.00 X 40.00	1000 "	13	5.00 M	3.00M ONE SIDE	2.50M.
H	20.00 X 35.00	700 SQM.	18	4.00 M	3.00M. ONE SIDE	2.00M.
HI	20.00 X 25.00	500 "	68	3.00 M	3.00M ONE SIDE	2.00M.
TOTAL NO. OF PLOTS			137			

LAND USE

(1)	TOTAL AREA UNDER SCHEME –	69.02 ACRES
(2)	" PLOTS	35.75 "
(3)	" ROADS	17.18 "
(4)	" GREEN BELT	5.83 "
(5)	" SERVICES	2.00 "
(6)	" P.H.E.D.	2.70 "
(7)	" COMMERCIAL COMPLEX	3.77 "
(8)	" OPEN	1.79 "
TOTAL –		69.02 ACRES

REVISION HAS BEEN MADE AS PER RM LETTER NO.4331 DT. 25.1.92 REVISED PORTION SHOWN IN RED.

SD- (B.S.PARIHAR) SR. PLG. ASSTT. SD- (HEMENT MURDIA) DY. TOWN PLANNER

REVISED LAYOUT PLAN OF INDUSTRIAL AREA GEGAL DISTT. AJMER

SCALE 1CM =40M.	DRG. NO.	1P1/136/91 DT.13.8.91
DRAWN BY	REV.1	1P1/168/92 DT.7.2.92
	REV.2	1P1/279/93 DT.8.9.93
	REV.3	1P1/324/94 DT.23-5-94
	REV.4	1P1/1266/03 DT.26-02-03
SD- (R.C. RAJORIA) SR.DRAUGHTS MAN		(R.C. RAJORIA) SR.DRAUGHTS MAN
SD- B.S.PARIHAR SR. PLANNING ASSTT.		D.K. SHARMA ASST.REGIONALMANAGER
SD- (B.R.P. BHATNAGAR) DY. TOWN PLANNER		(S.K.SHARMA) REGIONAL MANAGER

NOTE:-

- VACANT
- CONSTRUCTED / UNDER CONSTRUCTION
- UTILIZED & FUNCTIONAL
- UTILIZED BUT NOT FUNCTIONAL NOW



TO JAIPUR

TO AJMER